


PERMIT STRUCT  
 INSTALL OR MODIFY S.W. WASTEWATER FACILITY

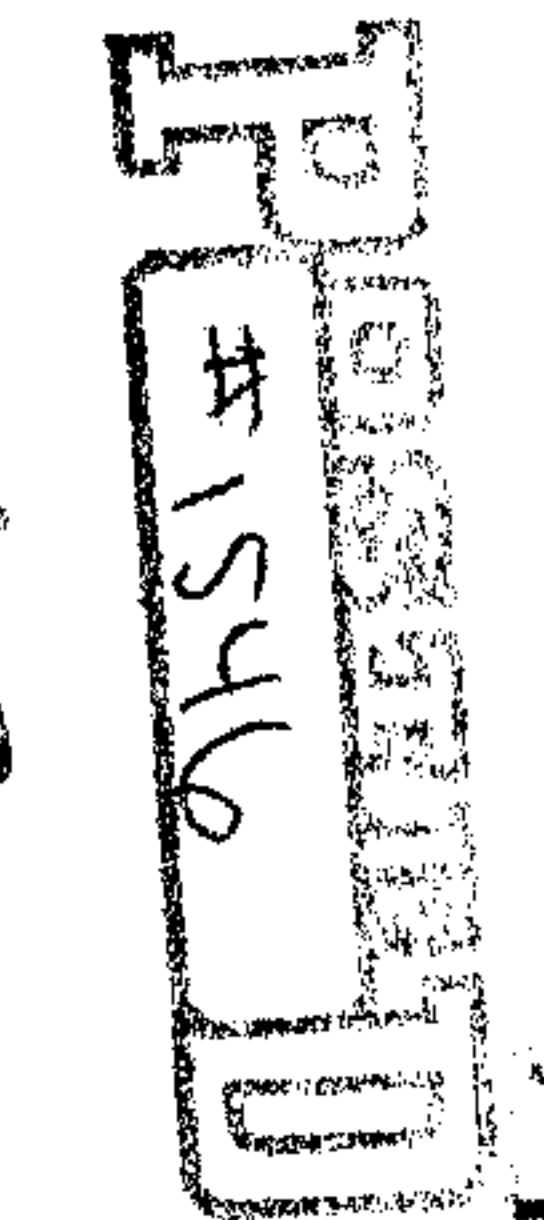

**"NOT TO BE USED FOR THE CONVEYANCE OF PROPERTY"**  
 Cheyenne-Laramie Co. Health Unit  
 Wyoming Department of Environmental Health  
 1000 Under Avenue  
 Cheyenne, WY 82001  
 307-638-8545

PERMIT NO. 1936  
 1216 Cole Rd.

*[Signature]*

Legal: R 68 T 14 Sec 9

Lot/Tract 45 Block 45

Size of Lot 6 ac +/- Slope \_\_\_\_\_

Subdivision Happy Valley First File

Owner Richard A Selby

Well installed:  5" PVC Yes  No

Address 1216 Cole Road Ph: 635-2224

Well to Septic tank (50' min.) 190' +/- ft.

Town/City Cheyenne WY Zip 82001

Well to final disposal (100' min.) 202' +/- ft.

Installer/Contractor Bobs Plumbing

Soil type \_\_\_\_\_ Perc. rate 1" in 14'

Type of Building Residence  
(residence, trailer, other, gallon per day)

Depth of sewer rock: Sized on 1" in 35'

**"NOT TO BE USED FOR THE CONVEYANCE OF PROPERTY"**

Number of bedrooms: three (3)

above pipe: 2" "below pipe: 18"

Septic tank gallons 1000 gallons

above pipe: 2" "below pipe: 24"

Secondary treatment Standard trench  
(trench, bed, other)

Material concrete, other

sq. ft. 400 width 24" lineal 200'

sq. ft. 480 width 24" lineal 240'

REMARKS: Run system perpendicular to slope 220' installed

APPLICANT'S SIGNATURE: [Signature] 56 ton

I certify that the installation of the Small Wastewater Facility described in this permit will be in compliance with Minimum Standards for Small Wastewater Facilities.

Preliminary approval [Signature] Date 5/23/85


Final approval [Signature] Date 7/31/85

**"NOT TO BE USED FOR THE CONVEYANCE OF PROPERTY"**

Nothing in this permit constitutes an endorsement of the construction or the design of the facility described herein. This permit indicates only that standards of design and construction required by the Laramie County Small Wastewater Facilities Regulations have been met. The County or the City-County Health Unit assumes no liability for, and does not in any way guarantee the performance of any Small Wastewater Facility.

This diagram is for office use only.  
It is not to scale & it's accuracy is not guaranteed.

"NOT TO BE USED"  
FOR THE CONVEYANCE  
OF PROPERTY

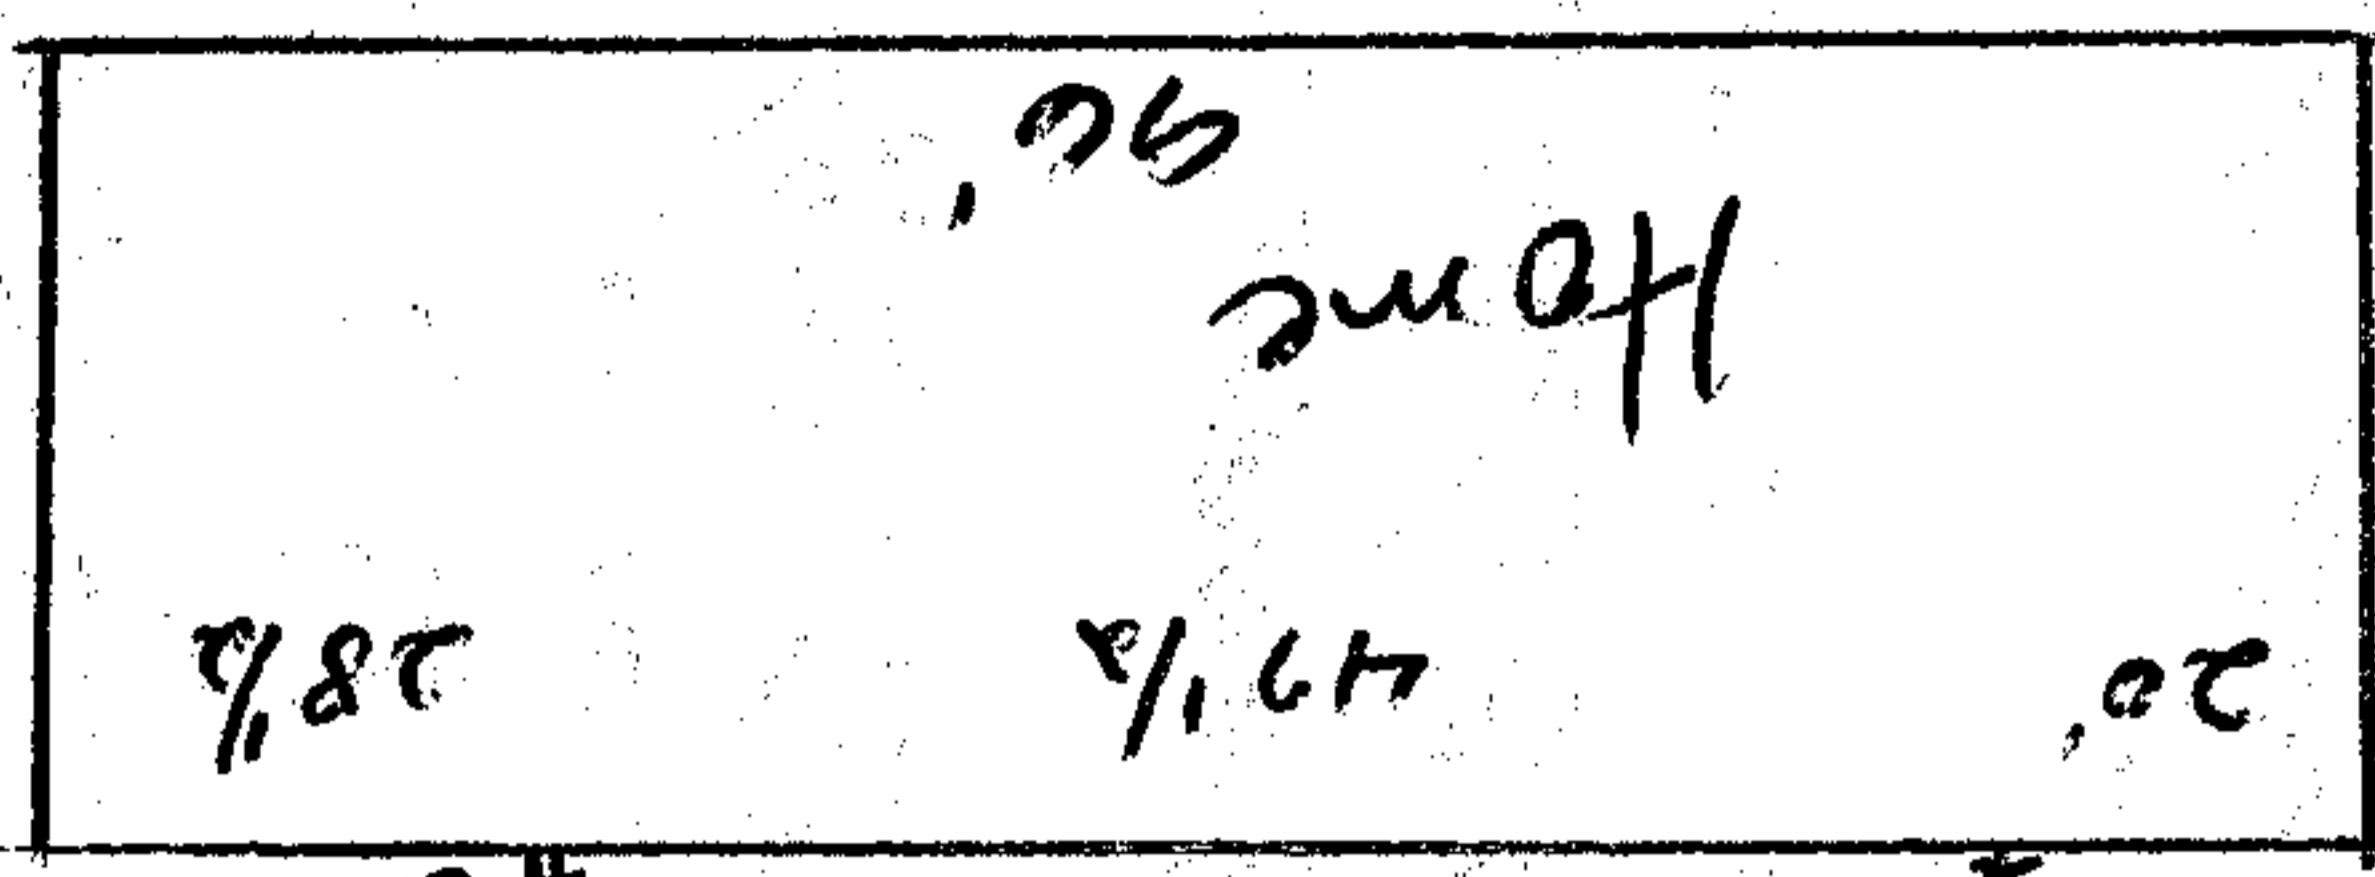

36'


118'

Well ⊕

This diagram is for office use only.  
It is not to scale & its accuracy is not guaranteed.

"NOT TO BE USED"  
FOR THE CONVEYANCE  
OF PROPERTY

1000 sq ft  
Prest  
Concrete

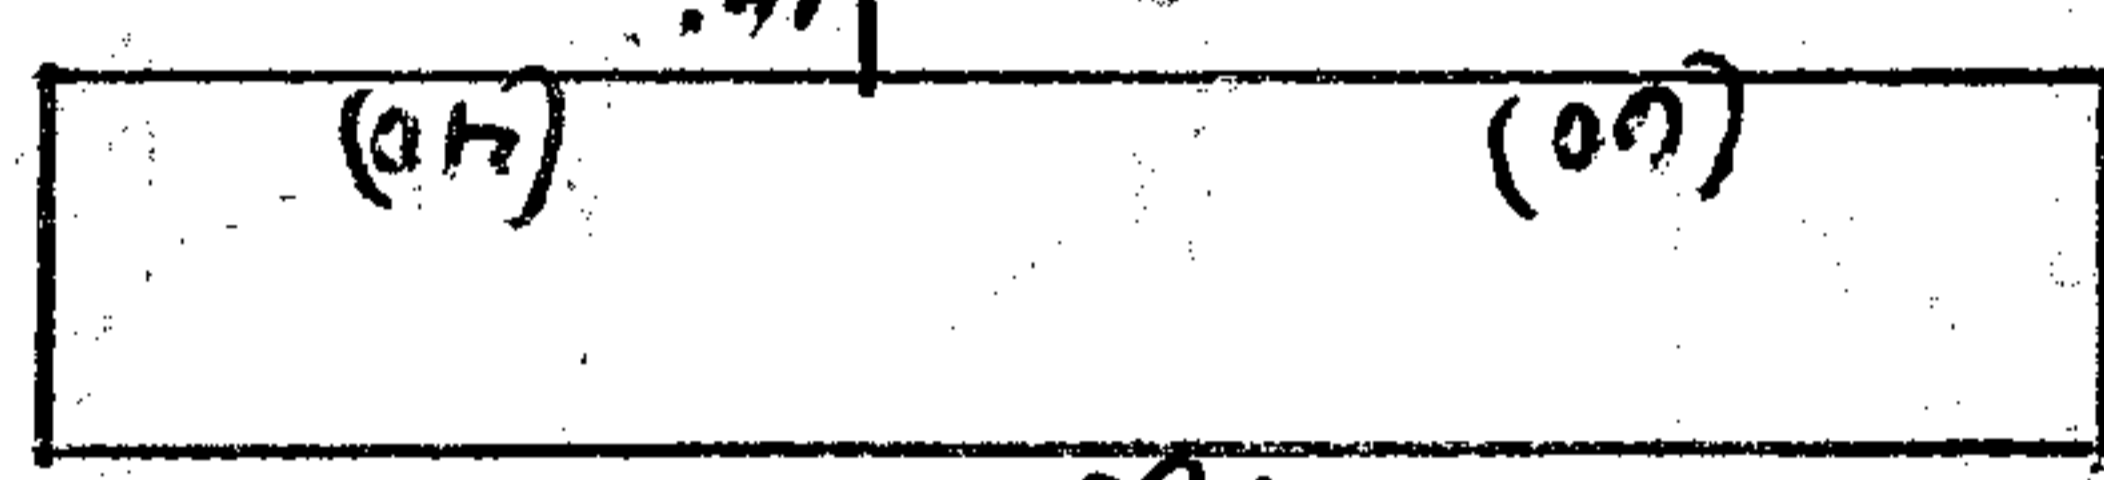

24" riser

"NOT TO BE USED"  
FOR THE CONVEYANCE  
OF PROPERTY

Driv

